
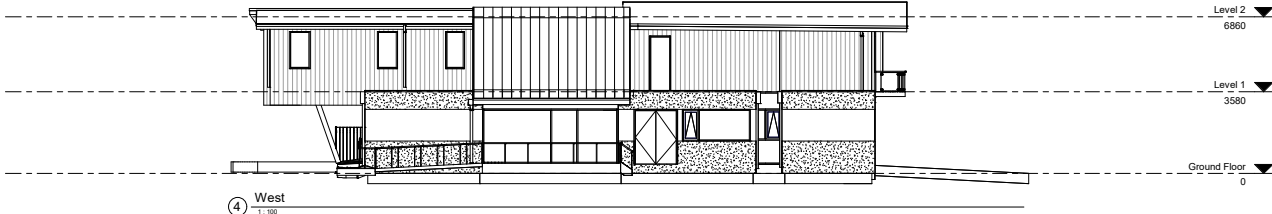
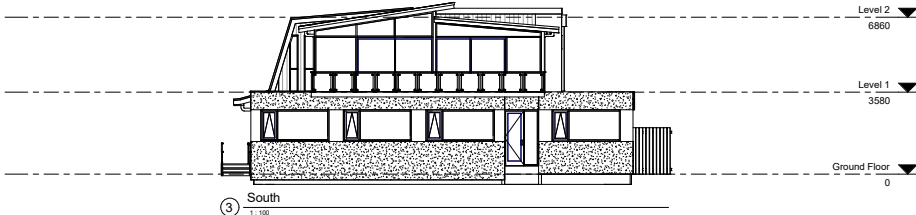
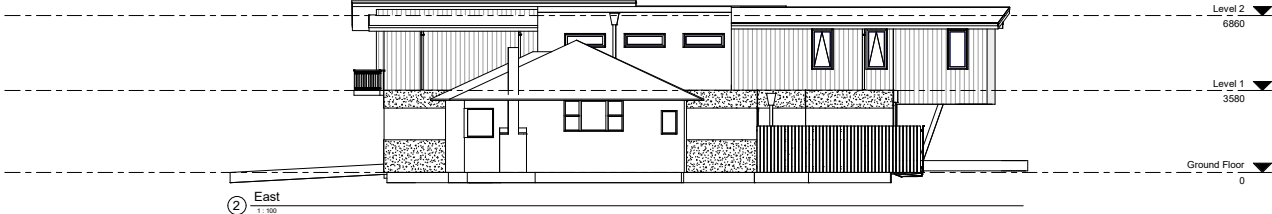


Notes:

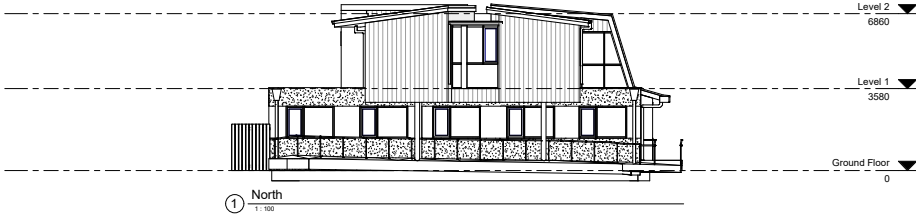

PROJECT STATUS:	As Built Survey
CLIENT:	REPAIR HUB
ARCHITECT:	N/A
SITE:	KENT RD PASCOE VALE
TITLE:	Elevations
SCALE:	1:100